



HUNTERS POND DAM REMOVAL AS-BUILT PLAN SCITUATE, MASSACHUSETTS

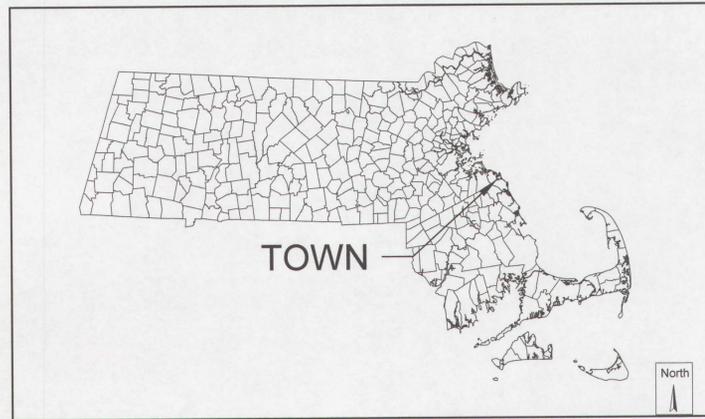

TOWN

MASSACHUSETTS


Graphic Scale
0 150000
SCALE IN FEET
1:150000

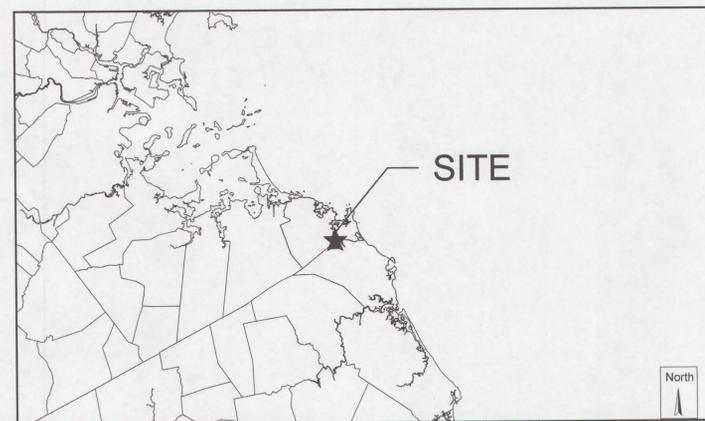

SITE

TOWN

Graphic Scale
0 12000
SCALE IN FEET
1:12000

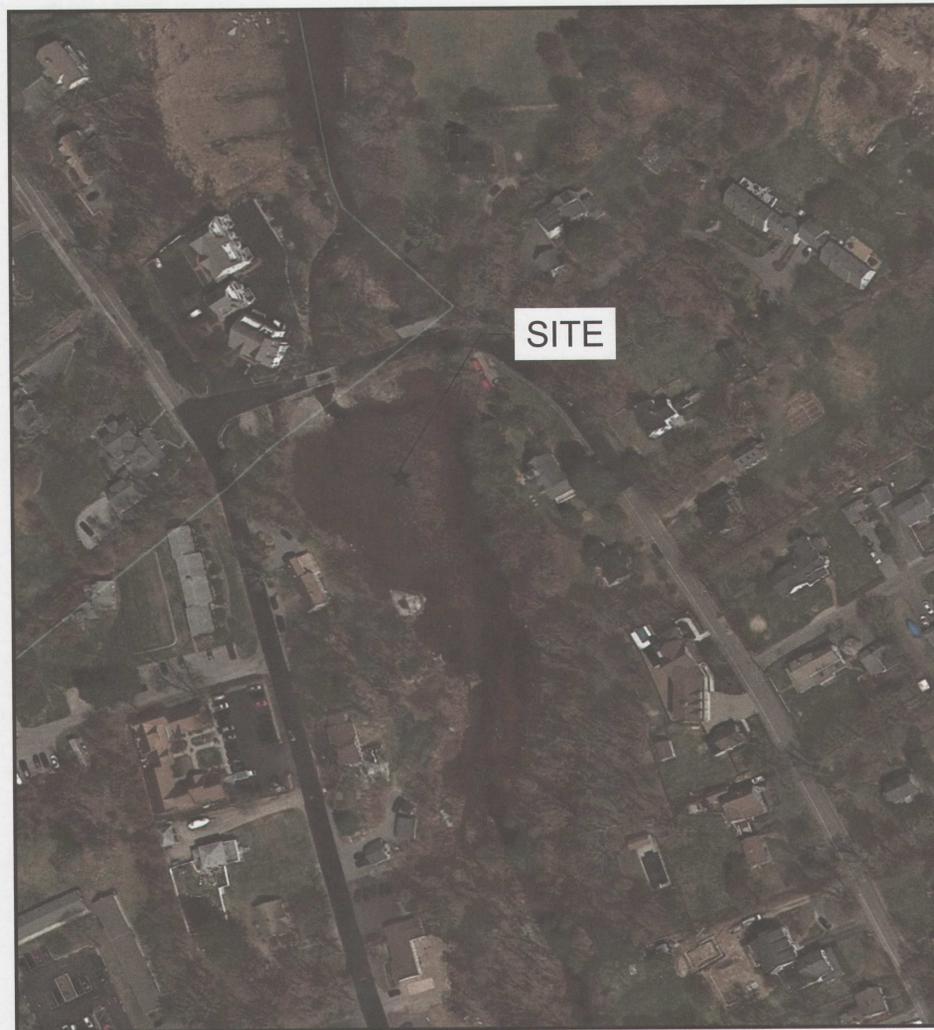

SITE


VICINITY MAP

Graphic Scale
1-inch = 100-feet


Plan Set:		HUNTERS POND DAM REMOVAL AS-BUILT PLAN SCITUATE, MASSACHUSETTS																																																								
Plan Date: September 12, 2018		Prepared For:																																																								
		Princeton Hydro, LLC PO Box 720, 1108 Old York Road Ringoes, NJ 08551 (908) 237-5660																																																								
Prepared By:		Horsley Witten Group, Inc. <i>Sustainable Environmental Solutions</i> www.horsleywitten.com																																																								
Headquarters 90 Route 6A Sandwich, MA 02563 (508) 833-6600 voice (508) 833-3150 fax	294 Washington Street, Suite 801 Boston, MA 02108 (857) 263-8193 voice (617) 574-4799 fax	55 Dorrance Street, Suite 200 Providence, RI 02906 (401) 272-1717 voice (401) 439-8368 fax	113 Water Street, R2 Exeter, NH 03833 (603) 658-1660																																																							
Registration:	Revisions		Project Number:																																																							
	<table border="1"> <thead> <tr> <th>Rev.</th> <th>Date</th> <th>By</th> <th>Appr.</th> <th>Description</th> </tr> </thead> <tbody> <tr><td> </td><td> </td><td> </td><td> </td><td> </td></tr> </tbody> </table>		Rev.	Date	By	Appr.	Description																																																			17124A
Rev.	Date	By	Appr.	Description																																																						
			Sheet Number:																																																							
			1 of 4																																																							
			Drawing Number:																																																							
			C - 1																																																							

TRANSECT MONUMENTS

PT ID	NORTHING	EASTING	ELEV.	DESCRIPTION	TRANSECT ID
12	2907103.01	848902.73	8.25	REBAR/CAP SET	TRANSECT A-1
155	2907143.66	848999.37	14.27	REBAR/CAP SET	TRANSECT A-2
157	2907067.48	848783.66	14.29	REBAR/CAP SET	TRANSECT A-2
151	2907140.31	848807.62	11.23	REBAR/CAP SET	TRANSECT A-3
152	2907220.66	848976.73	13.03	REBAR/CAP SET	TRANSECT A-3
153	2907303.99	848931.63	9.85	REBAR/CAP SET	TRANSECT A-4
150	2907248.71	848809.09	9.86	REBAR/CAP SET	TRANSECT A-4
154	2906930.59	849066.94	12.55	REBAR/CAP SET	TRANSECT C
158	2906858.57	848867.43	12.75	REBAR/CAP SET	TRANSECT C
163	2906736.83	849109.43	12.29	REBAR/CAP SET	TRANSECT D
164	2906702.08	848946.08	13.78	REBAR/CAP SET	TRANSECT D
161	2906536.28	848903.58	16.22	REBAR/CAP SET	TRANSECT E
162	2906629.14	849093.67	11.58	REBAR/CAP SET	TRANSECT E
159	2906553.53	849138.39	12.95	REBAR/CAP SET	TRANSECT F
160	2906482.10	849029.56	15.15	REBAR/CAP SET	TRANSECT F

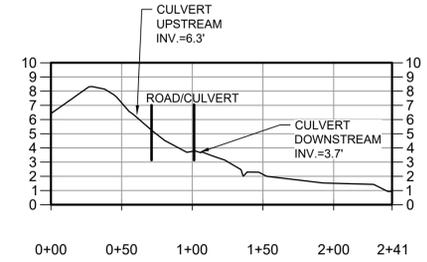

SECONDARY FLOW PATH
HORIZONTAL SCALE: 1" = 20'
VERTICAL SCALE: 1" = 2'

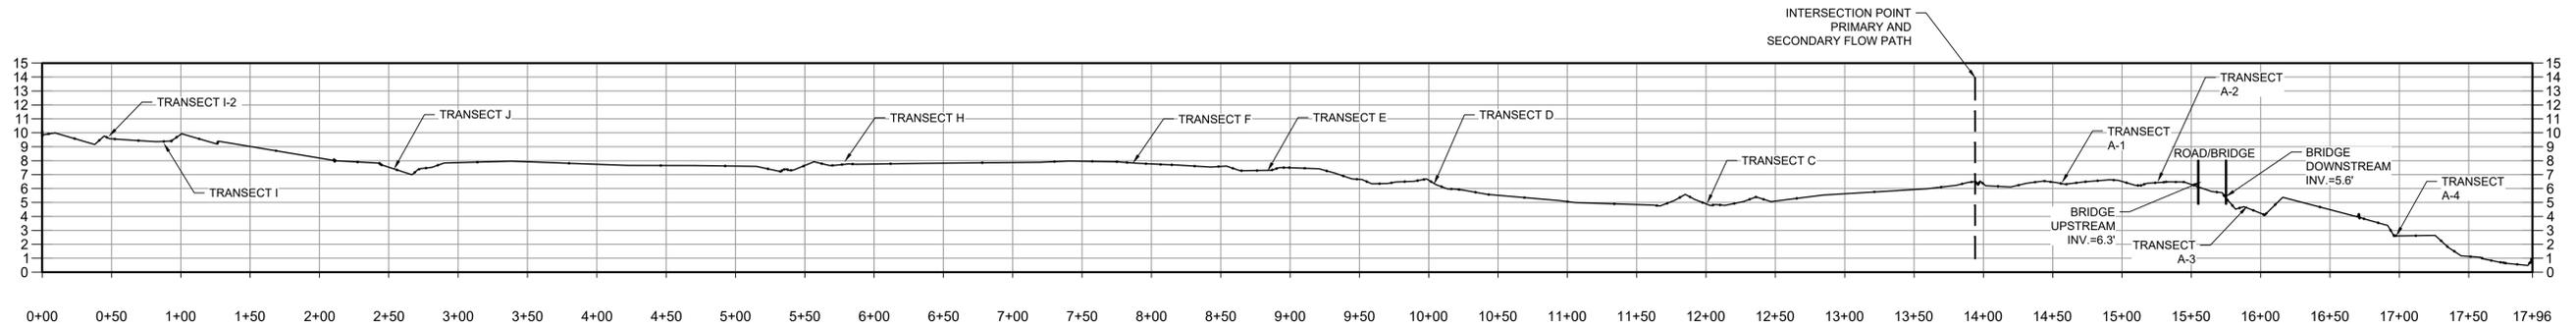

PRIMARY FLOW PATH
HORIZONTAL SCALE: 1" = 20'
VERTICAL SCALE: 1" = 2'



Revisions

Rev	Date	By	Appr	Description

Horsley Witten Group, Inc.
Sustainable Environmental Solutions
www.horsleywitten.com
90 Route 6A
Sandwich, MA 02563
508-833-6600 voice
508-833-3150 fax

Checked By: JUP
Drawn By: DWJ/GG
Designed By: ...
Date: SEPTEMBER 12, 2018

Plan Set:
**HUNTERS POND DAM REMOVAL
AS-BUILT PLAN
SCITUATE, MASSACHUSETTS**
Plan Title:
LONGITUDINAL PROFILE & PLAN VIEW

Prepared For:
Princeton Hydro, LLC
PO Box 720, 1108 Old York Road
Ringoes, NJ 08551
Phone: (908) 237-6660
Fax: ...


Survey Provided By:
Horsley Witten Group, Inc.
90 Route 6A
Sandwich, MA 02563
Phone: (508) 833-6600
Fax: (508) 833-3150
Dated: APRIL 2018

Project Number: 17124A
Sheet: 2 of 4


Sheet Number:
C - 2

last modified: 09/21/18 printed: 09/21/18 by dnm H:\Projects\2017\17124 Hunters Pond Dam Removal - T Ford Company\Drawings\17124A EX.dwg


last modified: 09/21/18 by dtn H:\Projects\2017\17124 Hunters Pond Dam Removal - T Ford Company\Drawings\17124A EX.dwg

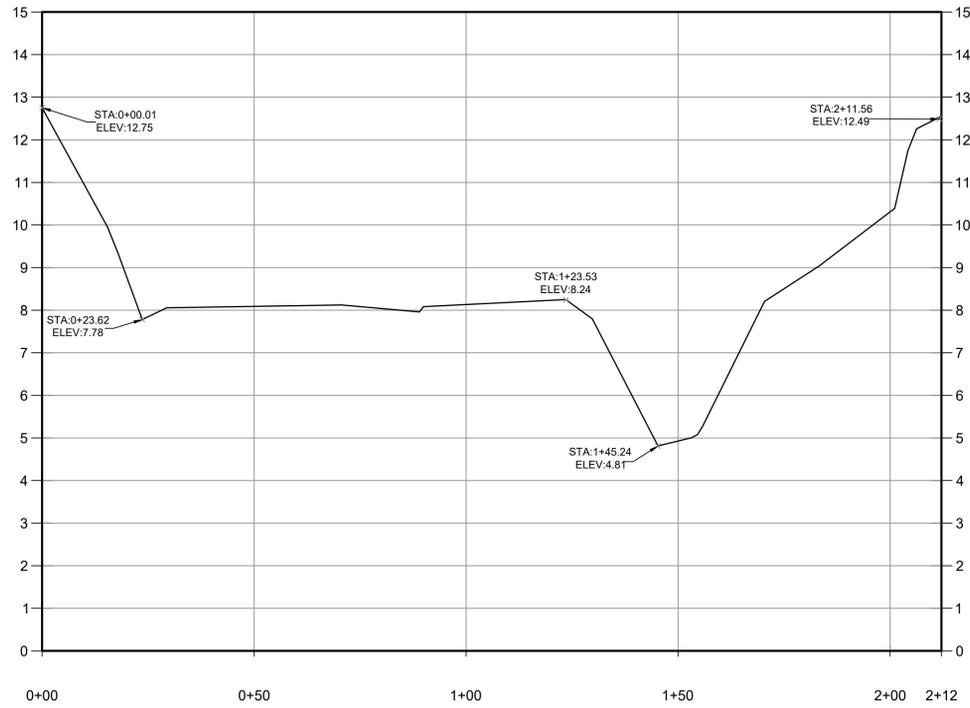


TRANSECT C
 HORIZONTAL SCALE: 1" = 20'
 VERTICAL SCALE: 1" = 2'

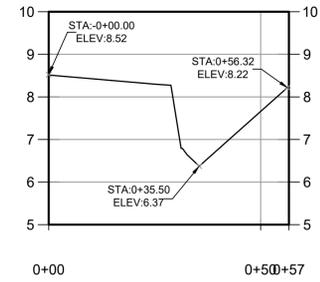


TRANSECT A-1
 HORIZONTAL SCALE: 1" = 20'
 VERTICAL SCALE: 1" = 2'

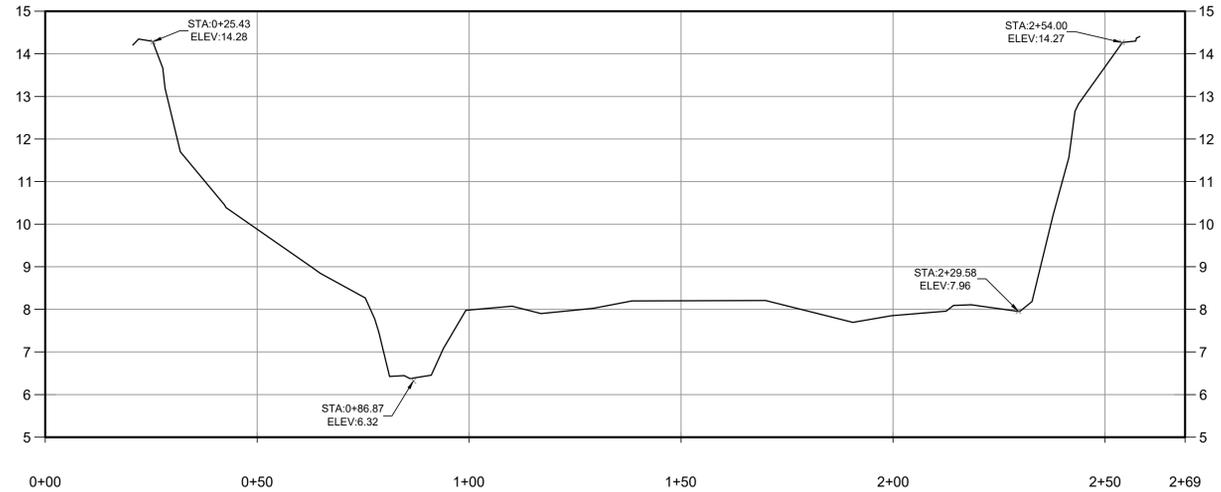

TRANSECT A-2
 HORIZONTAL SCALE: 1" = 20'
 VERTICAL SCALE: 1" = 2'

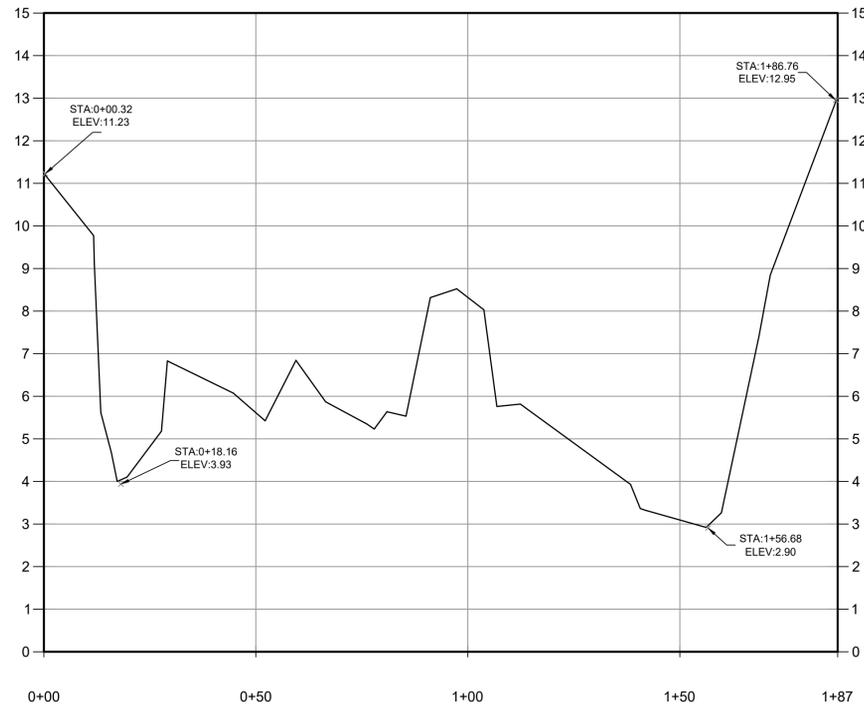

TRANSECT A-3
 HORIZONTAL SCALE: 1" = 20'
 VERTICAL SCALE: 1" = 2'

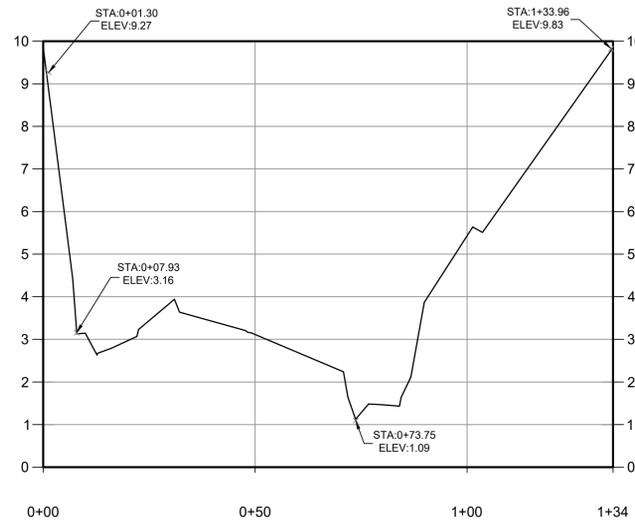

TRANSECT A-4
 HORIZONTAL SCALE: 1" = 20'
 VERTICAL SCALE: 1" = 2'

Revisions

Rev	Date	By	Appr	Description
1				
2				
Horsley Witten Group, Inc.
 Sustainable Environmental Solutions
 90 Route 6A
 Sandwich, MA 02563
 Phone: (508) 833-6600 voice
 508-833-3150 fax

**HUNTERS POND DAM REMOVAL
 AS-BUILT PLAN
 SCITUATE, MASSACHUSETTS**

Plan Set: TRANSECT SHEET 2

Prepared For:
Princeton Hydro, LLC
 PO Box 720, 1108 Old York Road
 Ringoes, NJ 08551
 Phone: (908) 237-5660
 Fax:

Survey Provided By:
Horsley Witten Group, Inc.
 90 Route 6A
 Sandwich, MA 02563
 Phone: (508) 833-6600
 Fax: (508) 833-3150
 Dated: APRIL 2018



Registration:

Project Number: 17124A
 Sheet: 4 of 4

Sheet Number: C - 4

SURVEY NOTES

1. THE TOPOGRAPHY AND EXISTING SITE CONDITIONS DEPICTED HEREON ARE THE RESULT OF AN ON THE GROUND FIELD SURVEY CONDUCTED BY THE HORSLEY WITTEN GROUP, INC. SEPTEMBER 27, 2017.
2. HORIZONTAL DATUM IS NORTH AMERICAN DATUM OF 1983 STATE PLANE MASSACHUSETTS. CONTROL TAKEN FROM PLANS TITLED "HUNTER'S POND DAM REMOVAL A.K.A MORDECAI LINCOLN ROAD DAM TOWN OF SCITUATE PLYMOUTH COUNTY, MASSACHUSETTS." PREPARED BY PRINCETON HYDRO, LLC. DATED DECEMBER 2, 2016.
3. ELEVATIONS ARE BASED ON NORTH AMERICAN VERTICAL DATUM 1988. BENCHMARK TAKEN FROM PLANS PROVIDED BY PRINCETON HYDRO, LLC. REFERENCED ABOVE.
4. NO PROPERTY LINE SURVEY WAS CONDUCTED DURING THE COMPILATION OF THIS AS-BUILT PLAN.
5. THE ACCURACY OF MEASURED PIPE INVERTS AND PIPE SIZES IS SUBJECT TO FIELD CONDITIONS, THE ABILITY TO MAKE VISUAL OBSERVATIONS, DIRECT ACCESS TO THE VARIOUS ELEMENTS AND OTHER CONDITIONS.
6. WATERLINE LOCATION AND TOP OF PIPE ELEVATIONS TAKEN FROM PLAN TITLED "AS-BUILT WATERMAIN HUNTERS POND" PREPARED BY THE TOWN OF SCITUATE DEPARTMENT OF PUBLIC WORKS DATED SEPTEMBER 21, 2017.

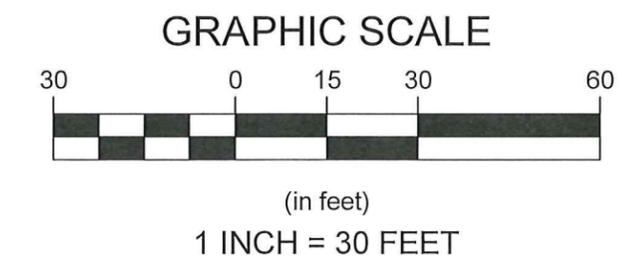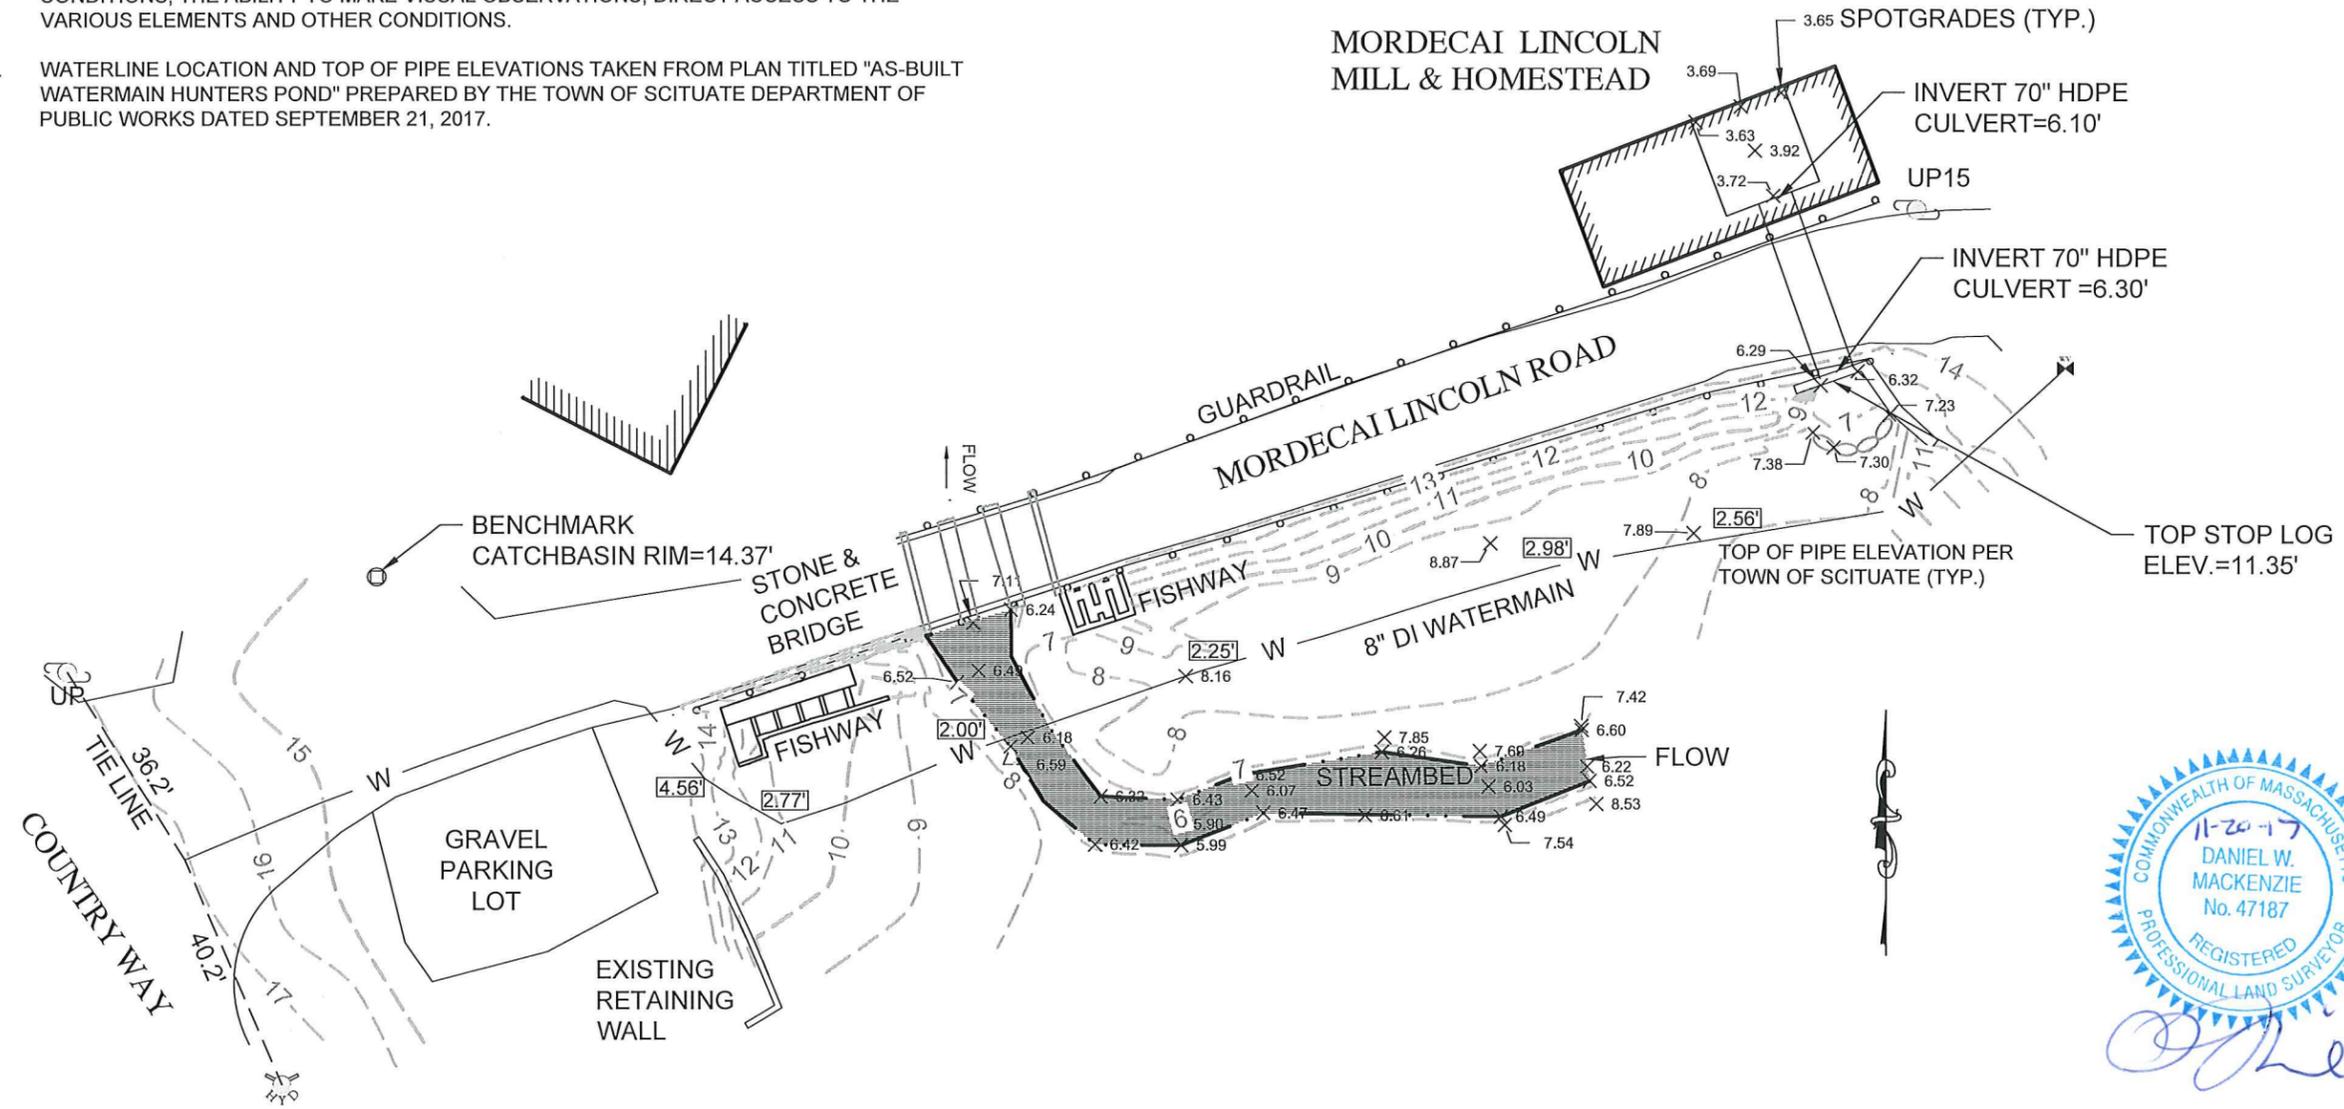

Revisions	Rev.	Date	By	Appr.	Description

Horsley Witten Group, Inc.
Sustainable Environmental Solutions
www.horsleywitten.com
90 Route 6A
Sandwich, MA 02563
508-833-6600 voice
508-833-3150 fax

Checked By: DWM
Drawn By: DWM
Design By: —
Date: OCT 18, 2017

Plan Set:
**HUNTERS POND DAM REMOVAL
MORDECAI LINCOLN ROAD
SCITUATE, MASSACHUSETTS**

Plan Title:
AS-BUILT CONDITIONS SURVEY

Prepared for:
T. Ford Company, Inc.
124 Tenney Street
Georgetown, MA 01833

Survey Provided By:
Horsley Witten Group, Inc.
90 Route 6A
Sandwich, MA 02544
Phone: (508) 833-6600
Fax: (508) 833-3150
September 27, 2017

Registration:

Project Number:
17124

Sheet Number:
1 of 1