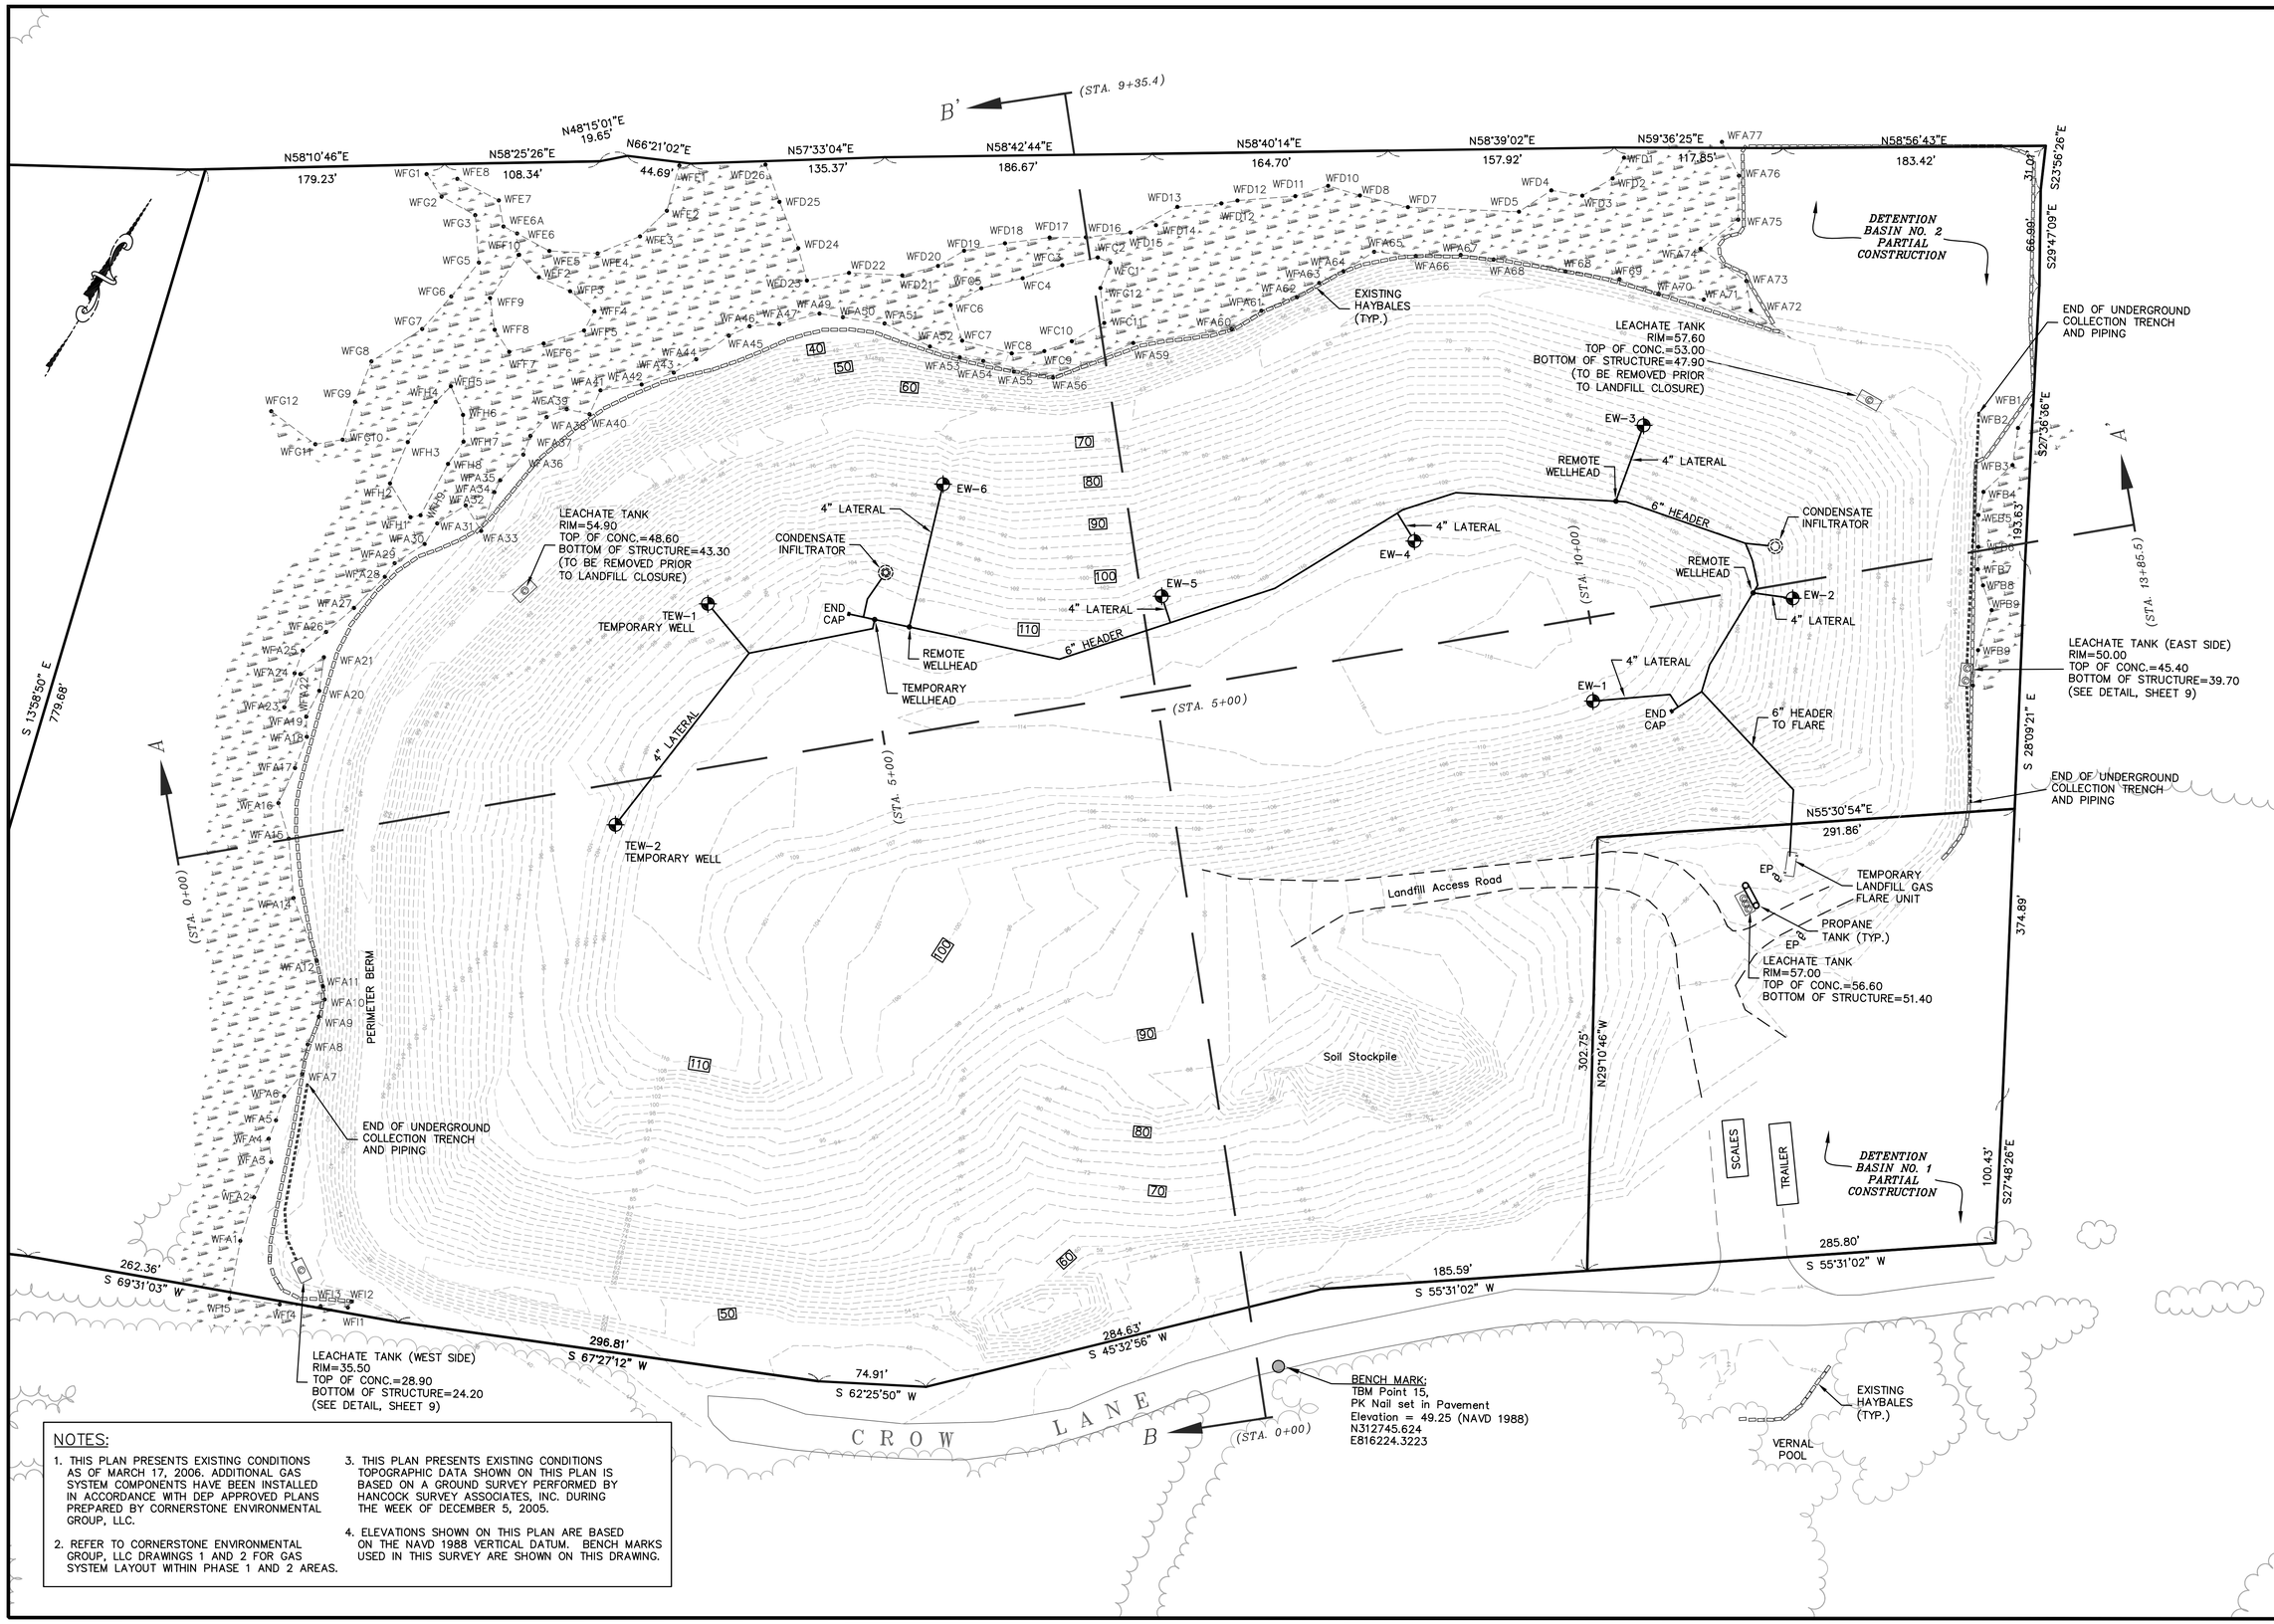

NOTES:

1. THIS PLAN PRESENTS EXISTING CONDITIONS AS OF MARCH 17, 2006. ADDITIONAL GAS SYSTEM COMPONENTS HAVE BEEN INSTALLED IN ACCORDANCE WITH DEP APPROVED PLANS PREPARED BY CORNERSTONE ENVIRONMENTAL GROUP, LLC.
2. REFER TO CORNERSTONE ENVIRONMENTAL GROUP, LLC DRAWINGS 1 AND 2 FOR GAS SYSTEM LAYOUT WITHIN PHASE 1 AND 2 AREAS.
3. THIS PLAN PRESENTS EXISTING CONDITIONS TOPOGRAPHIC DATA SHOWN ON THIS PLAN IS BASED ON A GROUND SURVEY PERFORMED BY HANCOCK SURVEY ASSOCIATES, INC. DURING THE WEEK OF DECEMBER 5, 2005.
4. ELEVATIONS SHOWN ON THIS PLAN ARE BASED ON THE NAVD 1988 VERTICAL DATUM. BENCH MARKS USED IN THIS SURVEY ARE SHOWN ON THIS DRAWING.

No.	Date	Revision Description	Chkd. by	Appvd. by
1	12/20/06	ADDED NOTATION		

scale: 1"=50'
date: MAR. 17, 2006
drawn: JAC
checked: MQ
approved: ARQ
drawing number: 2

project: CORRECTIVE ACTION DESIGN
CROW LANE LANDFILL
NEWBURYPORT, MASSACHUSETTS

client: NEW VENTURES ASSOCIATES, L.L.C.

drawing title: EXISTING CONDITIONS & COLLECTION SYSTEM AS-BUILT

SITEC ENVIRONMENTAL
Civil and Environmental Engineering
Land Use Planning Services
Hazardous and Solid Waste Consultants
769 Plain Street, Unit C
Marshfield, MA 02050
PHONE (781) 319-0100
FAX (781) 834-4783

Acad No. NBP CAD EC.dwg
File No. SE05-533