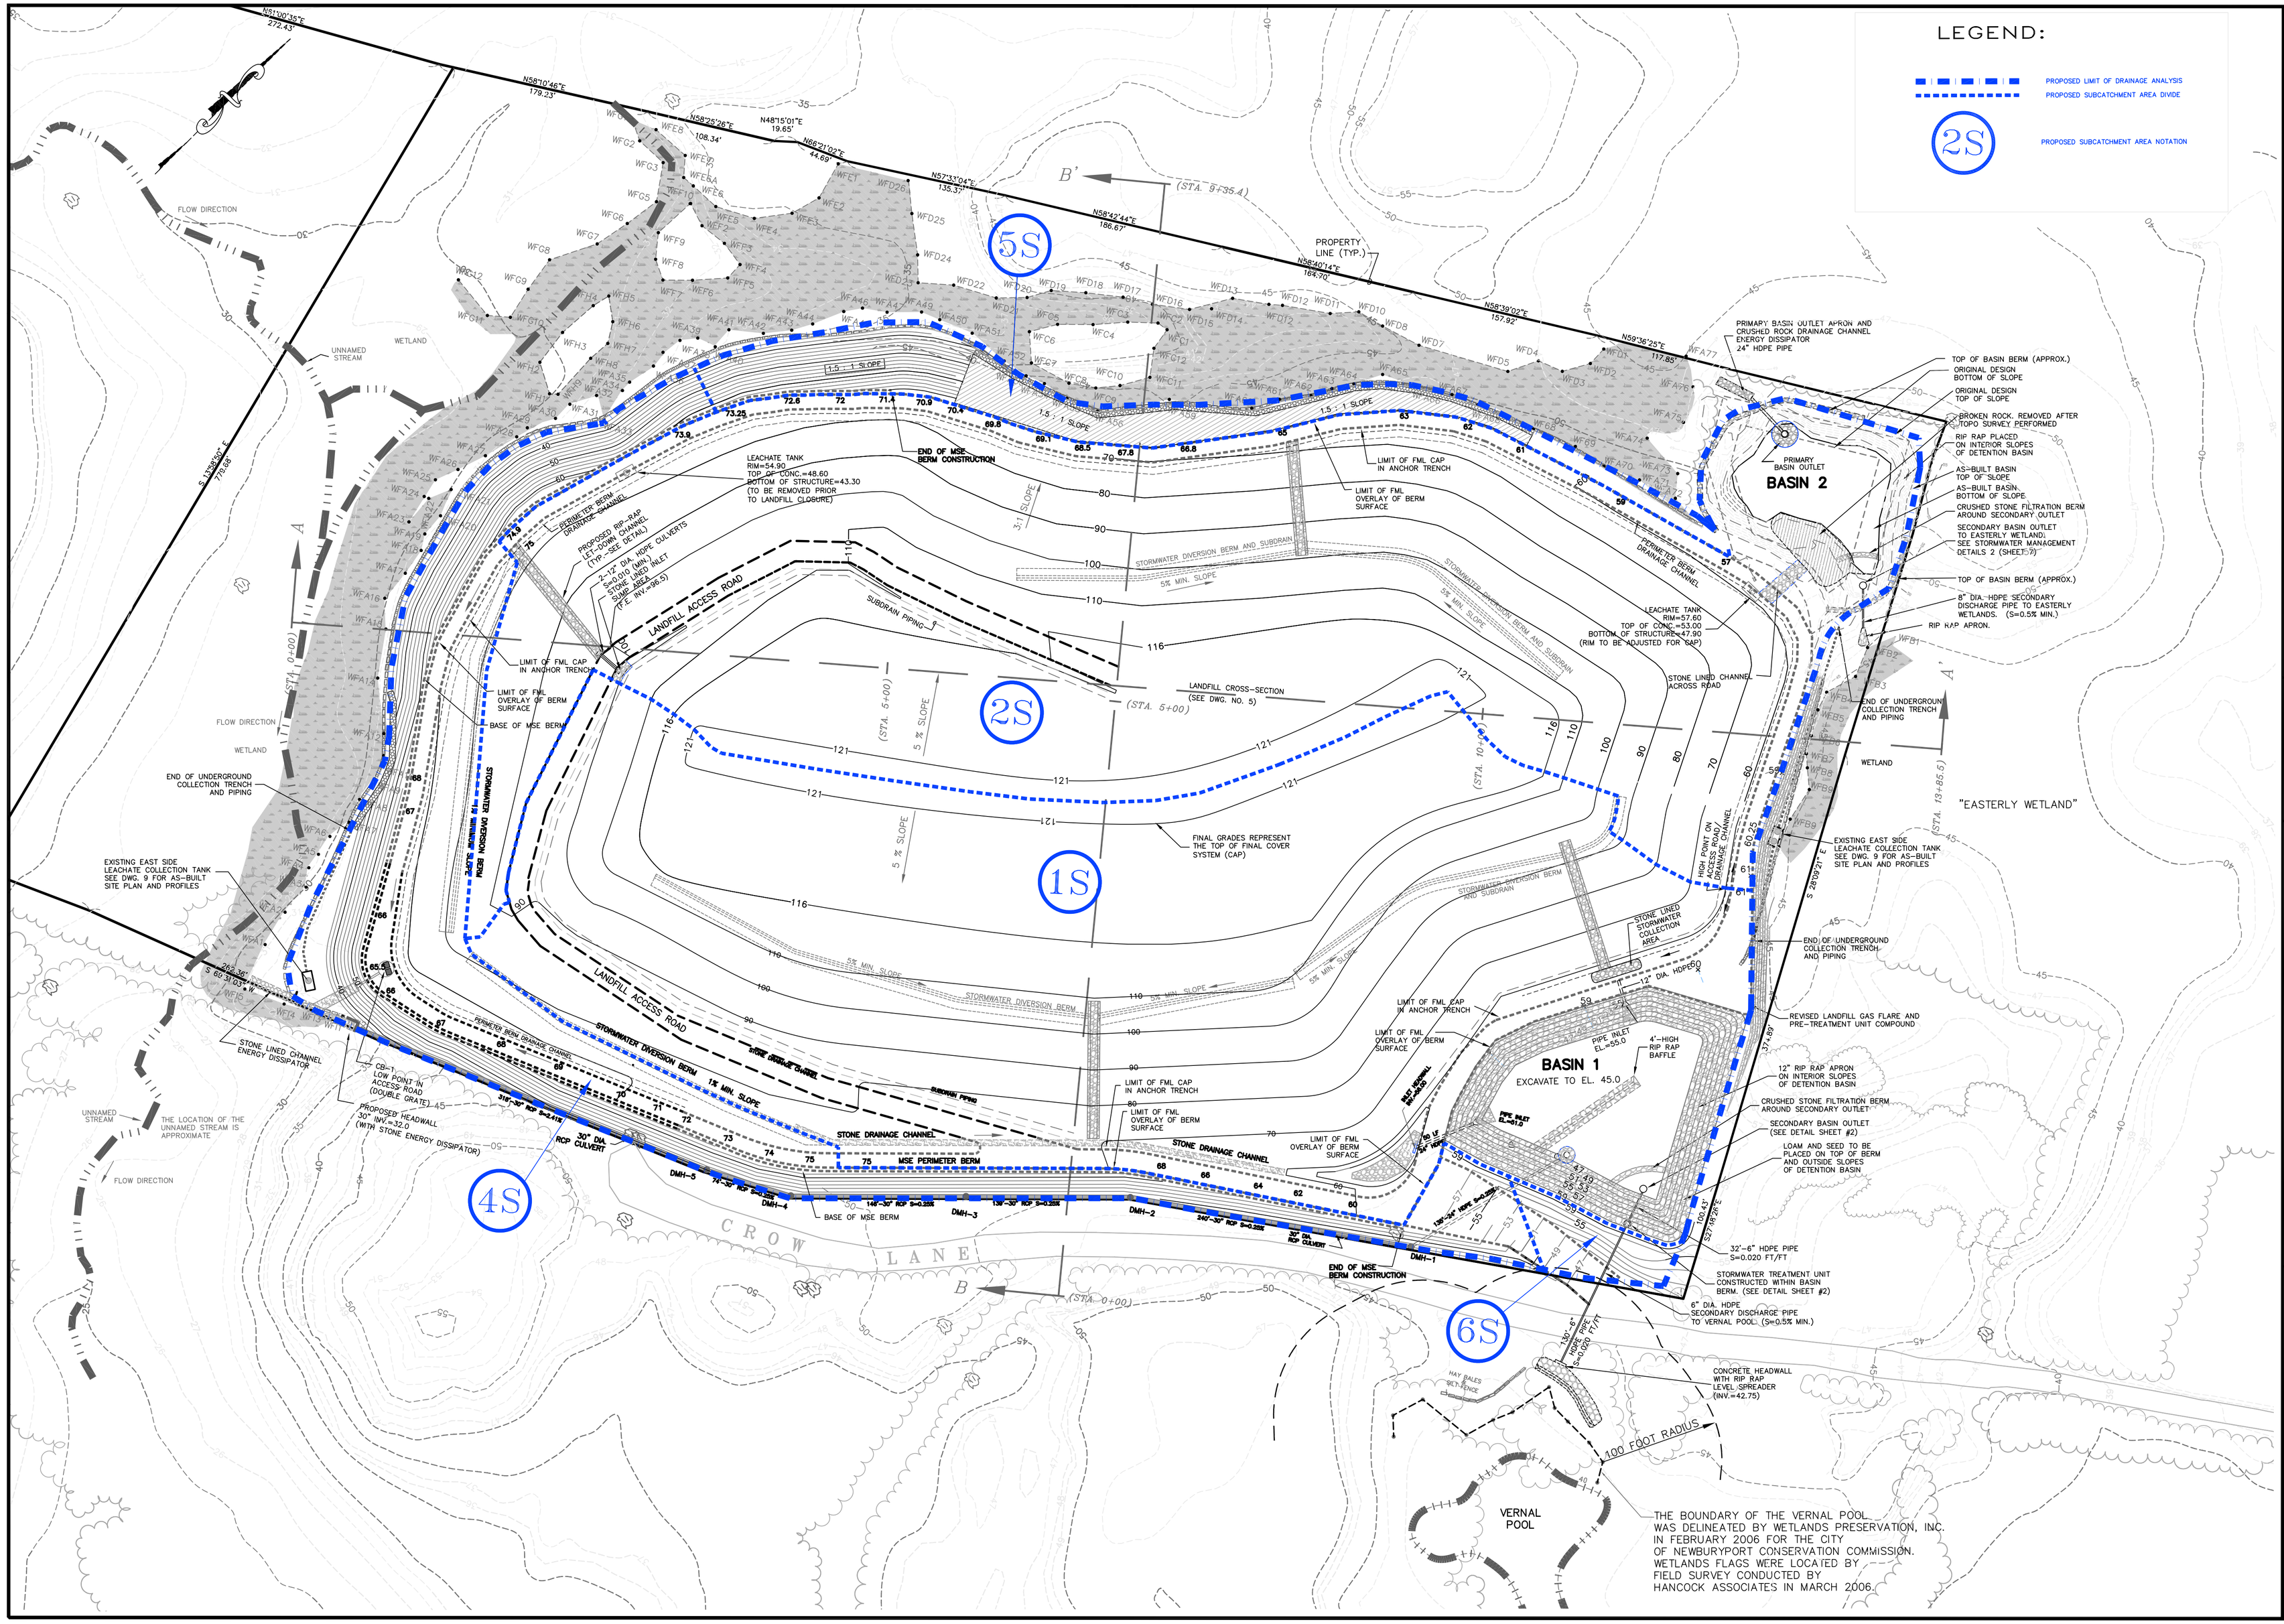

No.	Date	Revision Description	Chkd. by	Apprvd. by
1	4/7/06	ADDED VERNAL POOL DELINEATION		
2	4/7/06	CHANGED DRAWING SCALE FROM 1"=50' TO 1"=60'		
3	4/7/06	ADDED UNNAMED STREAM AND WETLANDS LABELS		
4	12/20/06	ADDED SECONDARY BASIN OUTLETS		
5	12/20/06	ADDED NOTATION		
6	5/9/07	REVISED SOUTH BERM AND DRAINAGE		
7	6/25/07	REVISED BASIN 2 CONTOURS PER AS-BUILT SURVEY		

scale: 1"=60'
date: MAR. 17, 2006
drawn: JAC
checked: MQ
approved: ARQ
drawing number: —

project: CORRECTIVE ACTION DESIGN
CROW LANE LANDFILL
NEWBURYPORT, MASSACHUSETTS

client: NEW VENTURES ASSOCIATES, L.L.C.

drawing title: POST-CLOSURE DRAINAGE AREA PLAN

SITEC ENVIRONMENTAL
Civil and Environmental Engineering
Land Use Planning and Surveying
Hazardous and Solid Waste Consultants
769 Plain Street, Unit C
Marshfield, MA 02050
PHONE (781) 319-0100
FAX (781) 834-4783

Acad No.
File No.